

LEGEND

PROPOSED DISTURBED AREA

PERMIT BOUNDARY


SECTION LINE

CONTOUR LINE

DRAINAGE

CULVERTS

SEE APPENDICES 3-O & 3-P FOR CROSS SECTION PROFILES
SEE PLATES 2-4 FOR PRE-1977 DISTURBANCE

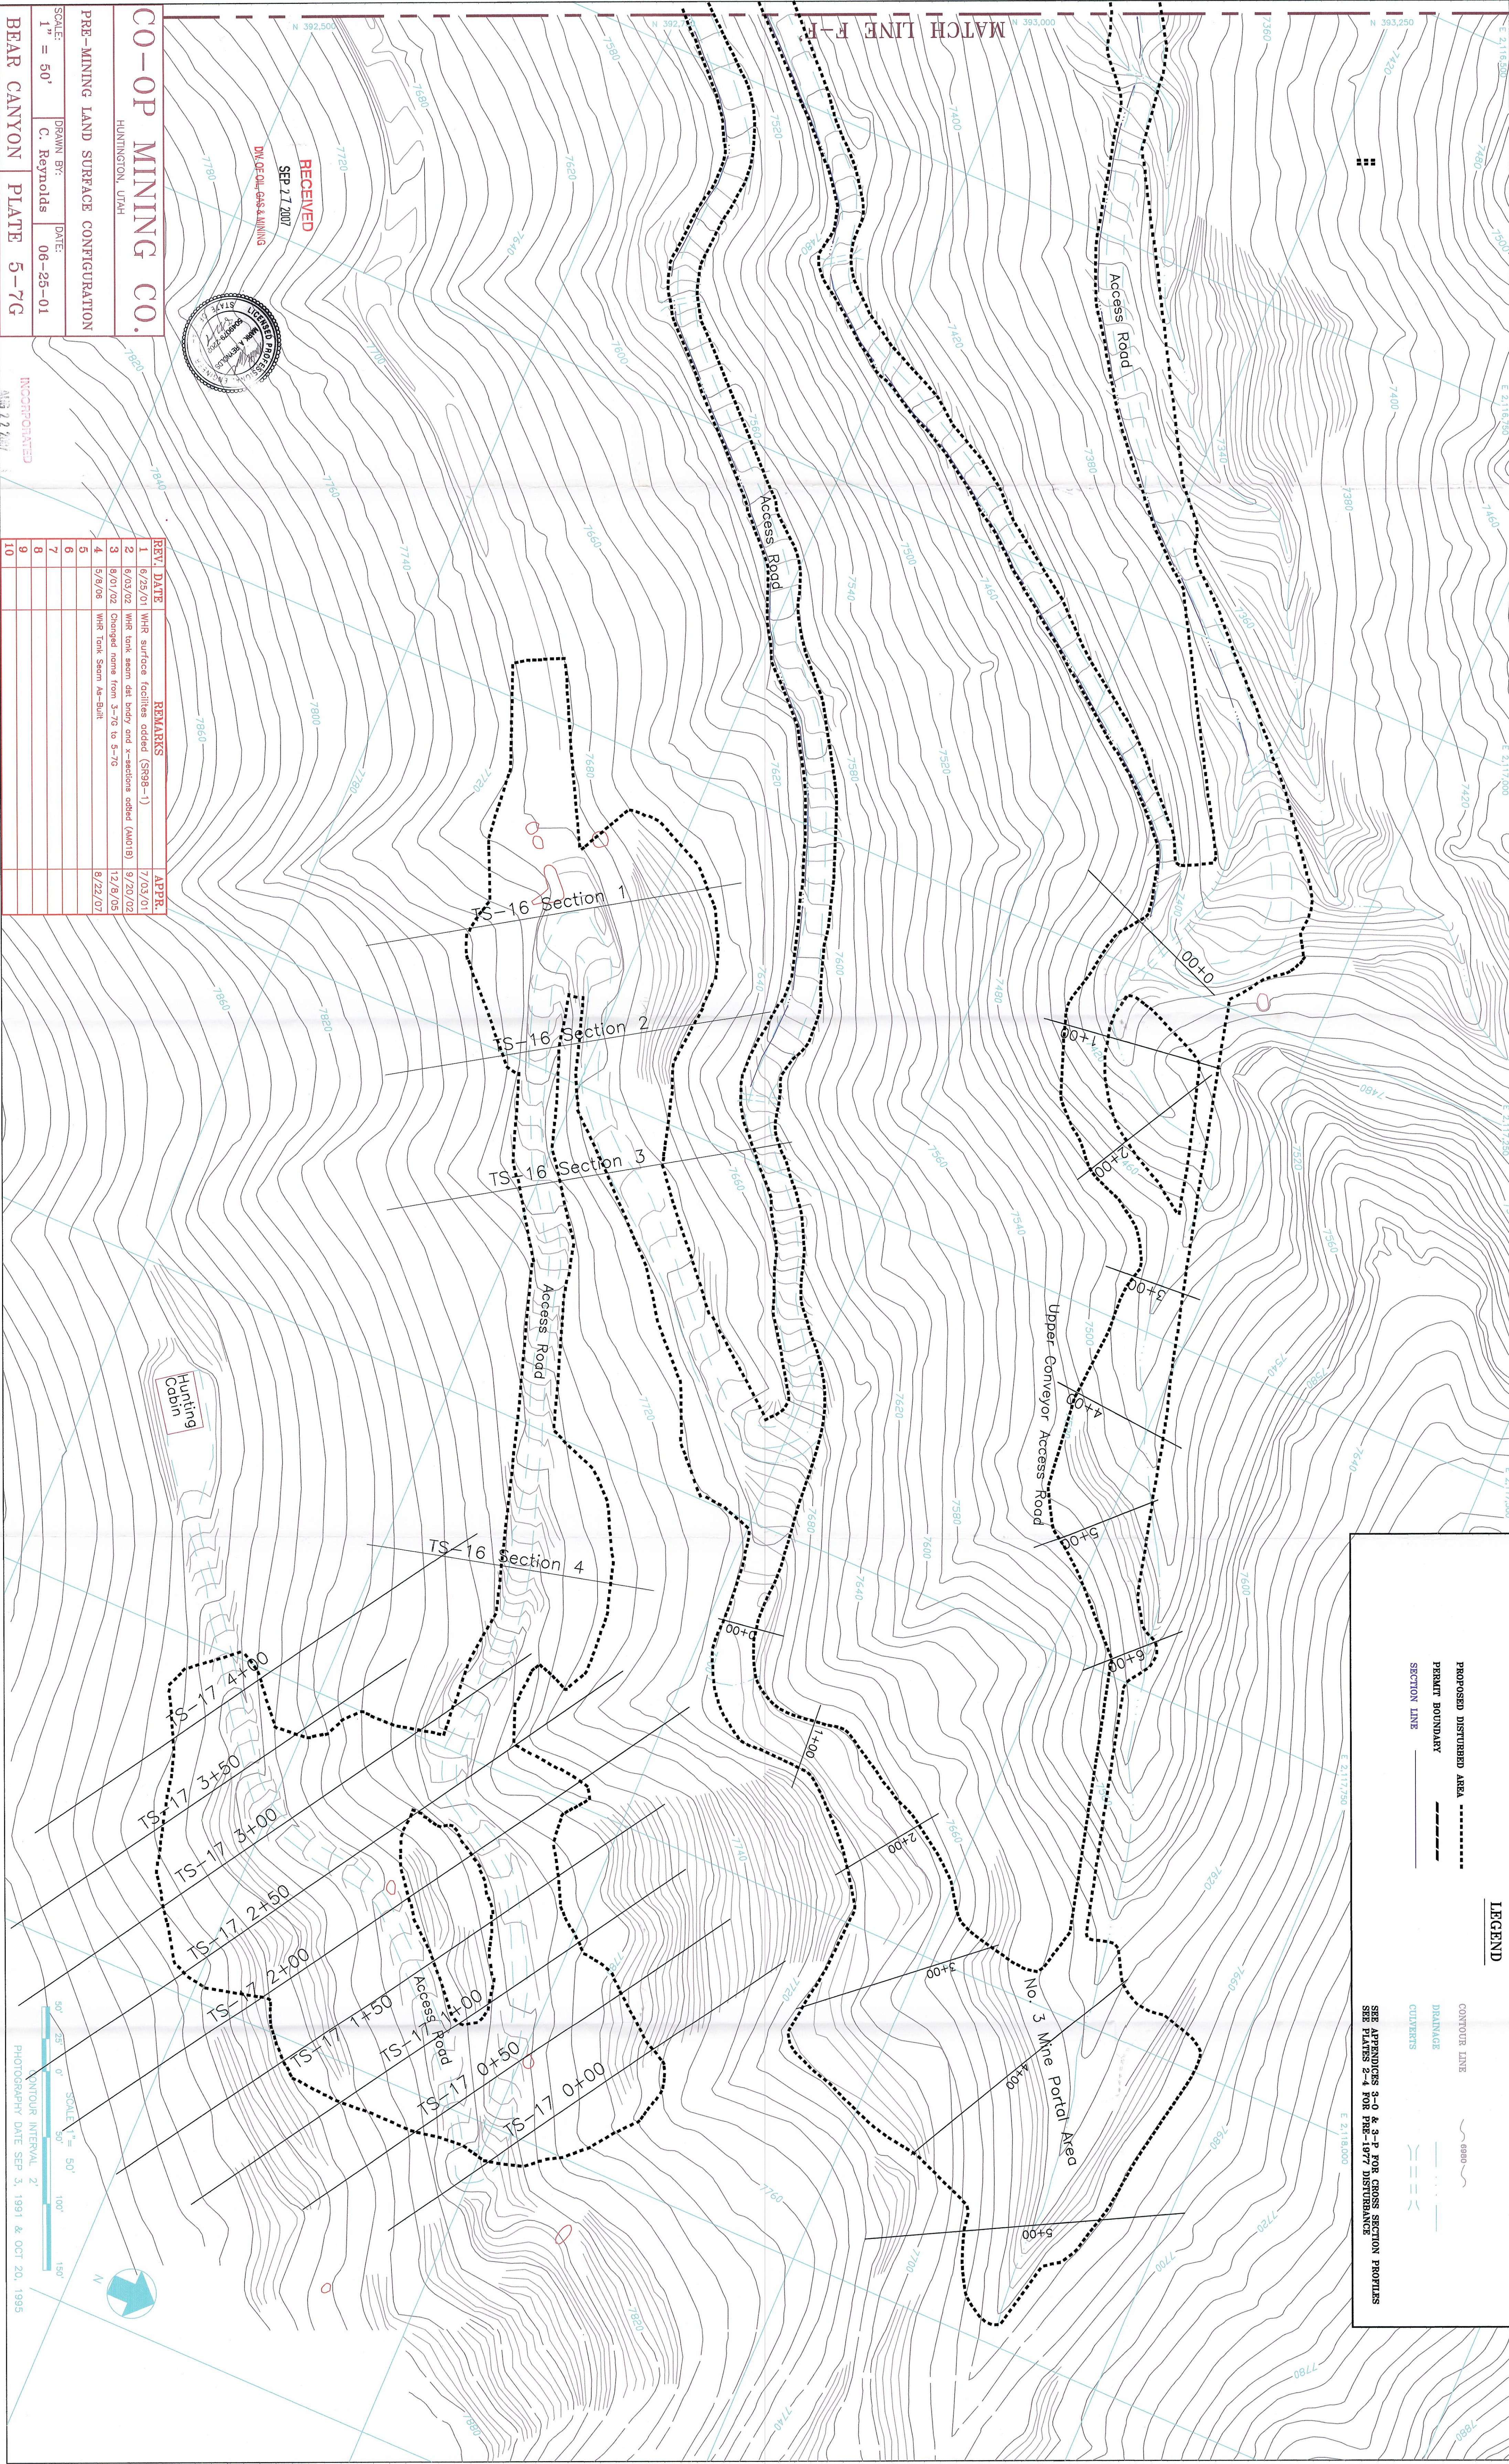

CO-O P MINING CO.
HUNTINGTON, UTAH

PRE-MINING LAND SURFACE CONFIGURATION

SCALE: 1" = 50'
DRAWN BY: C. Reynolds
DATE: 06-25-01

BEAR CANYON PLATE 5-7G

REV.	DATE	REMARKS	APPR.
1	6/25/01	WHR surface facilities added (SR98-1)	7/03/01
2	6/03/02	WHR tank seam dot body and x-sections added (AM019)	9/20/02
3	6/01/02	Changed name from 5-7G to 5-7G	12/9/05
4	5/6/06	WHR tank seam As-Built	8/22/07
5			
6			
7			
8			
9			
10			

INCORPORATED
MAY 12, 2011

CONTOUR INTERVAL 2'

SCALE 1" = 50'

PHOTOGRAPHY DATE SEP 3, 1991 & OCT 20, 1995